



# INDEX

A1 -	1	INDEX
A1 -	2	3D VIEW - ARENA DISTRICT AERIAL
A1 -	3	OVERALL SITE PLAN
A1 -	4	ENLARGED SITE PLAN - 6TH & JUNEAU
A1 -	5	ENLARGED SITE PLAN - 4TH & JUNEAU
A1 -	6	ENLARGED SITE PLAN - 6TH & HIGHLAND
A1 -	7	ENLARGED SITE PLAN - 4TH & HIGHLAND
A1 -	8	OVERALL GRADING PLAN
A1 -	9	OVERALL SITE EROSION CONTROL PLAN
A1 -	10	OVERALL UTILITY PLAN
A1 -	11	ENLARGED LANDSCAPE PLAN - 4TH & JUNEAU
A1 -	12	ENLARGED LANDSCAPE PLAN - 4TH & HIGHLAND
A1 -	13	ENLARGED LANDSCAPE PLAN - 6TH & HIGHLAND
A1 -	14	ENLARGED LANDSCAPE PLAN - 6TH & JUNEAU
A1 -	15	SITE AREA LIGHTING - LIGHTING PLAN & CALCULATIONS
A1 -	16	SITE AREA LIGHTING - PHOTOMETRIC STUDY
A1 -	17	SITE AREA LIGHTING - PRODUCT CUTSHEETS
A1 -	18	SITE ELEMENT - INTERACTIVE MOMUMENT SIGNAGE
A1 -	19	NORTHWEST ENTRANCE - LED PRODUCT INFORMATION & REFERENCE IMAGES
A1 -	20	3D VIEW - NORTHWEST ENTRANCE - DAYTIME
A1 -	21	3D VIEW - NORTHWEST ENTRANCE - EVENING

## BLOCK 1 - WISCONSIN ENTERTAINMENT & SPORTS CENTER MINOR MODIFICATION - DRAFT

POPULOUS

HNTB

eua

eppstein uhlen - architects




WISCONSIN ENTERTAINMENT & SPORTS CENTER

1111 N. 4TH STREET  
MILWAUKEE WI

DPD - MINOR MODIFICATION

REVISIONS		
NO.	DATE	DESCRIPTION
1	03.17.2016	ISSUED
2	04.04.2016	REVISED
3	05.09.2016	REVISED
4	01.27.2017	REVISED

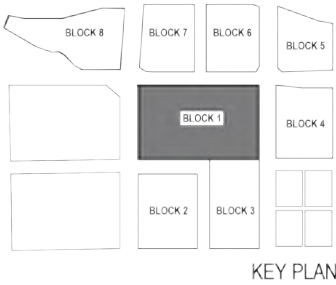

PROJECT NUMBER: 15.4017

ISSUE DATE: 01.27.2017

INDEX

POPULOUS

HNTB

eua

SHEET

A1 - 1






# **WISCONSIN ENTERTAINMENT & SPORTS CENTER**

**1111 N. 4TH STREET  
MILWAUKEE WI**

DPD - MINOR MODIFICATION

## REVISIONS

NO.	DATE	DESCRIPTION
1	03.17.2016	ISSUED
2	04.04.2016	REVISED
3	05.09.2016	REVISED
4	01.27.2017	REVISED

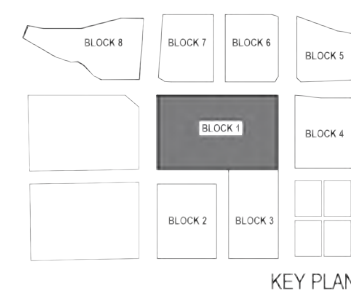

PROJECT NUMBER: 15.4017


ISSUE DATE: 01.27.2017

3D VIEW - ARENA DISTRICT AERIAL

**POPULOUS** **HNTB** **eua**

**SHEET  
A1 - 2**



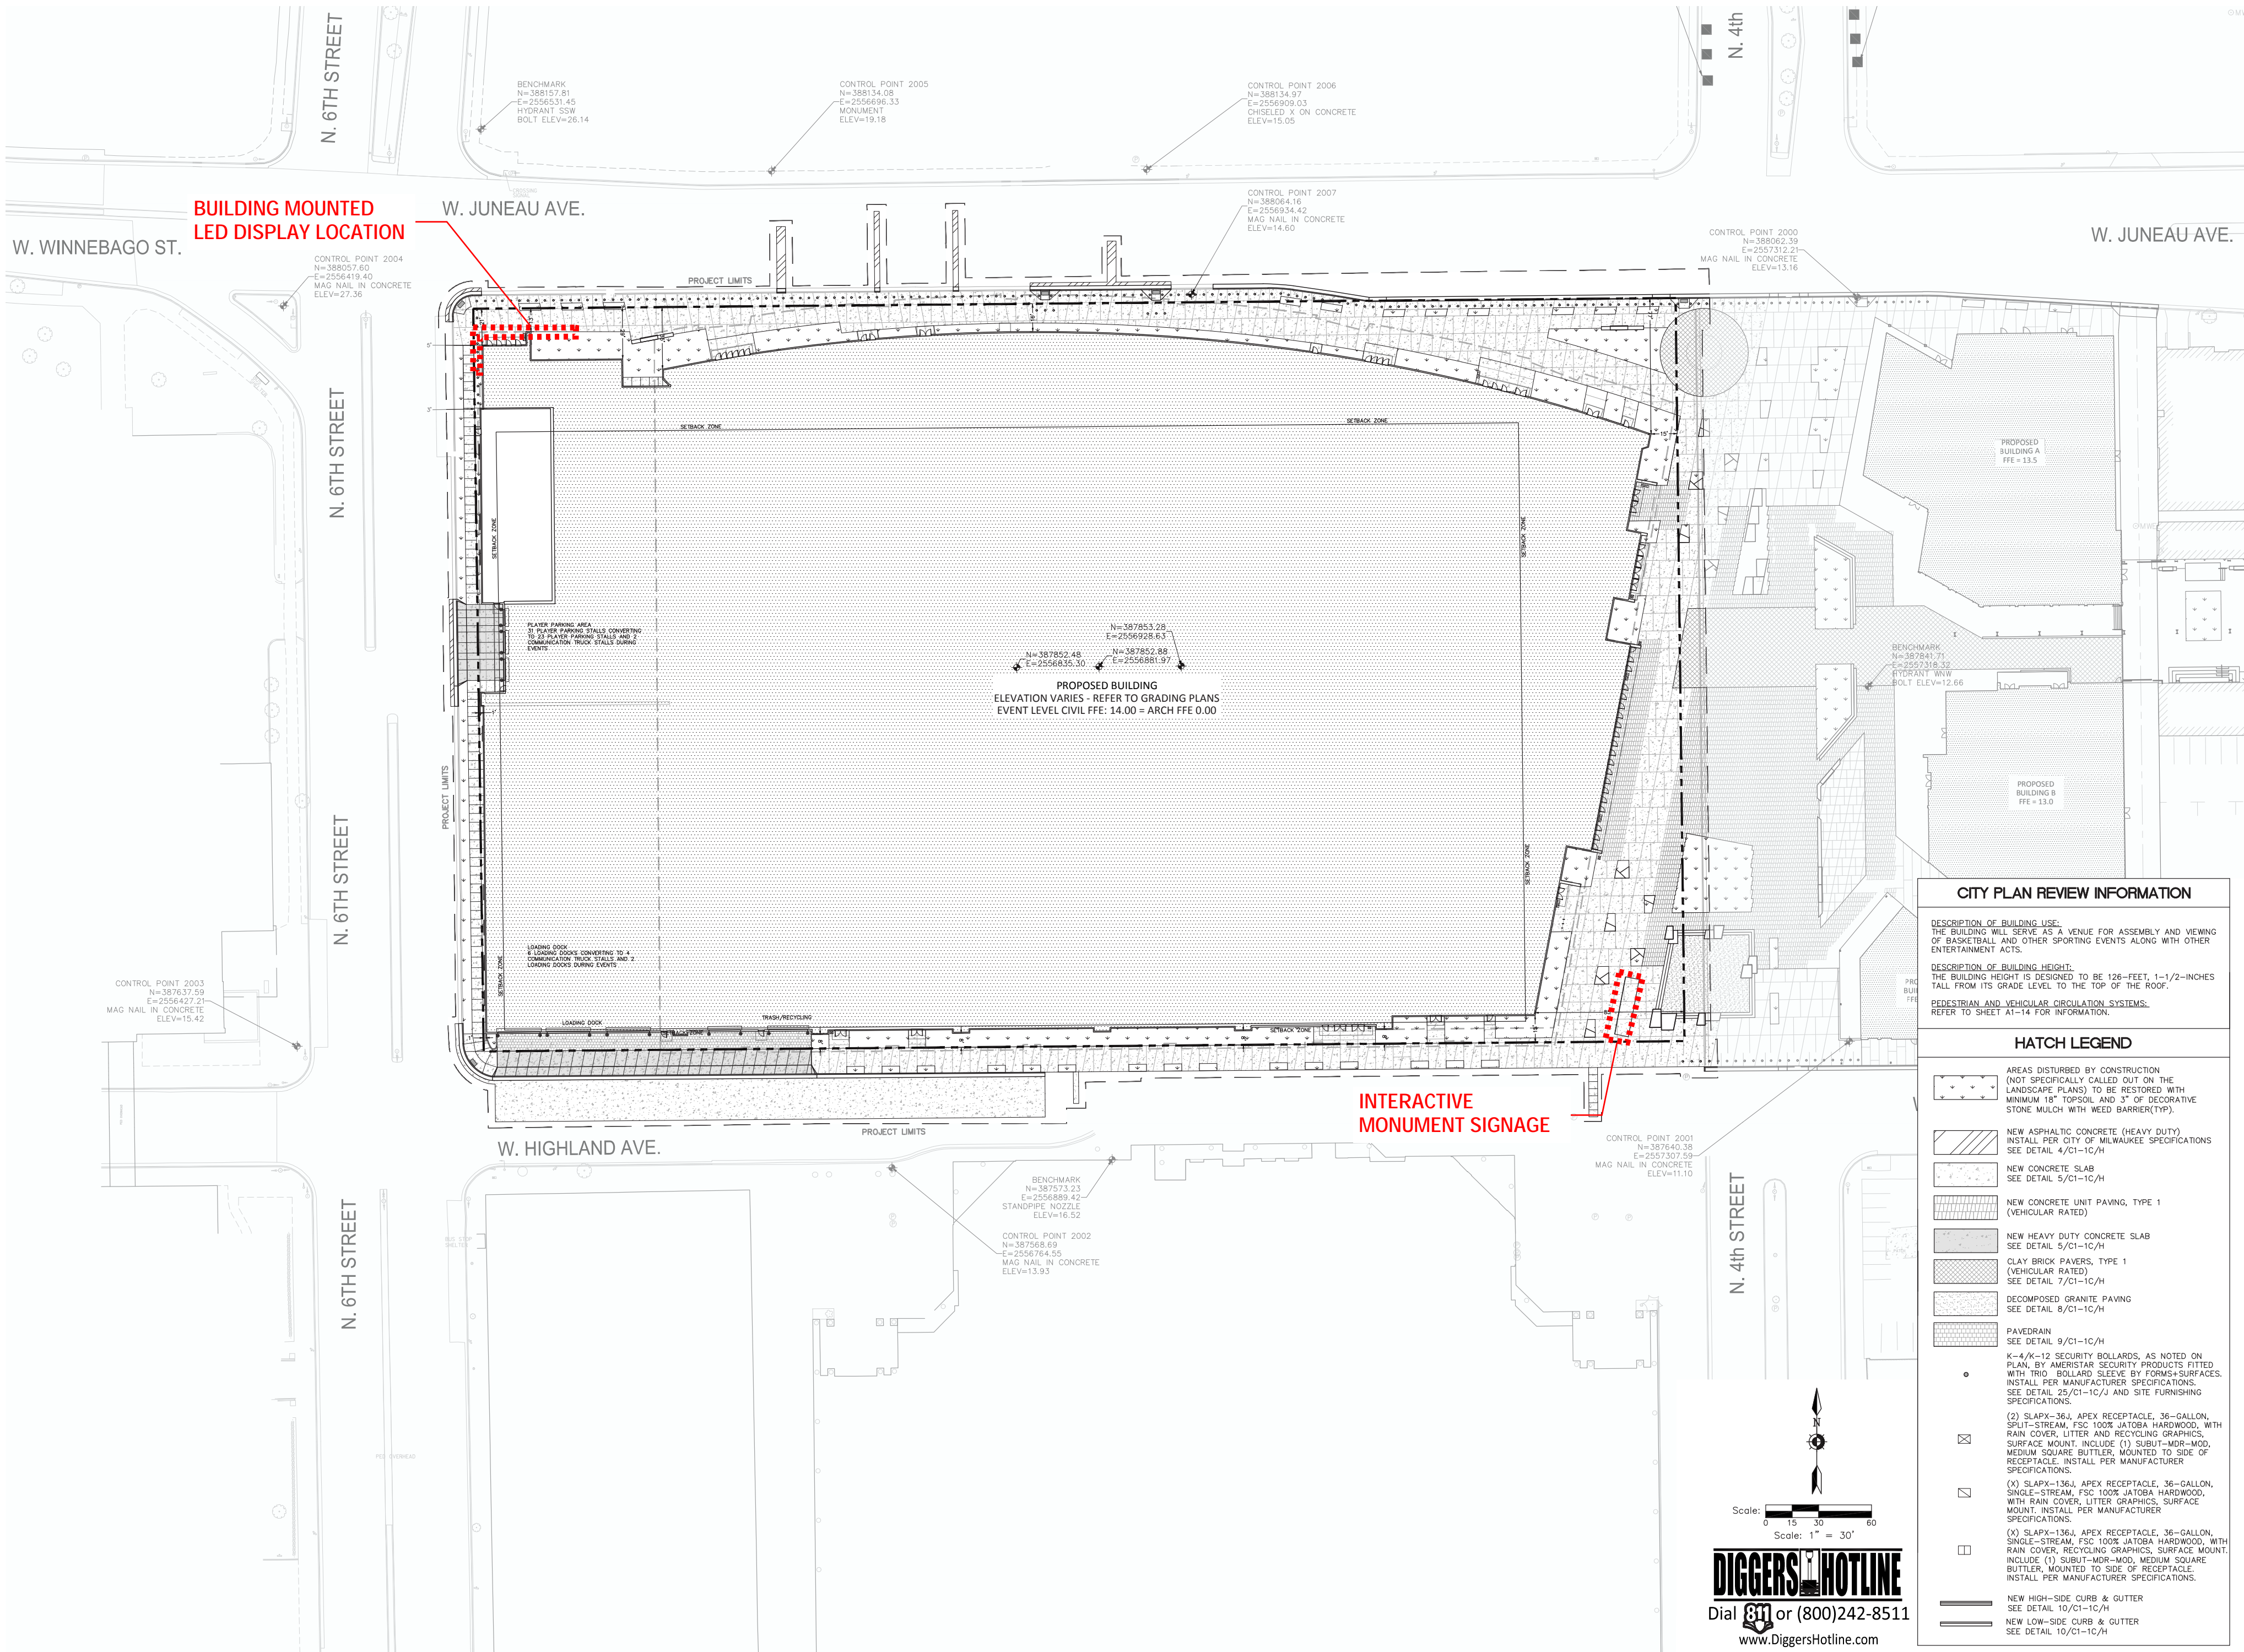

**CITY PLAN REVIEW INFORMATION**

**DESCRIPTION OF BUILDING USE:**  
THE BUILDING WILL SERVE AS A VENUE FOR ASSEMBLY AND VIEWING OF BASKETBALL AND OTHER SPORTING EVENTS ALONG WITH OTHER ENTERTAINMENT ACTS.

**DESCRIPTION OF BUILDING HEIGHT:**  
THE BUILDING HEIGHT IS DESIGNED TO BE 126-Feet, 1-1/2-INCHES TALL FROM ITS GRADE LEVEL TO THE TOP OF THE ROOF.

**PEDESTRIAN AND VEHICULAR CIRCULATION SYSTEMS:**  
REFER TO SHEET A1-14 FOR INFORMATION.

**HATCH LEGEND**

AREAS DISTURBED BY CONSTRUCTION (NOT SPECIFICALLY CALLED OUT ON THE LANDSCAPE PLANS) TO BE RESTORED WITH MINIMUM 18" TOPSOIL AND 3" OF DECORATIVE STONE MULCH WITH WEED BARRIER(TYP).

NEW ASPHALTIC CONCRETE (HEAVY DUTY) INSTALL PER CITY OF MILWAUKEE SPECIFICATIONS SEE DETAIL 4/C1-1C/H

NEW CONCRETE SLAB SEE DETAIL 5/C1-1C/H

NEW CONCRETE UNIT PAVING, TYPE 1 (VEHICULAR RATED)

NEW HEAVY DUTY CONCRETE SLAB SEE DETAIL 5/C1-1C/H

CLAY BRICK PAVERS, TYPE 1 (VEHICULAR RATED) SEE DETAIL 7/C1-1C/H

DECOMPOSED GRANITE PAVING SEE DETAIL 8/C1-1C/H

PAVEDRAIN SEE DETAIL 9/C1-1C/H

K-4/K-12 SECURITY BOLLARDS, AS NOTED ON PLAN, BY AMERISTAR SECURITY PRODUCTS FITTED WITH TRIO BOLLARD SLEEVE BY FORMS+SURFACES. INSTALL PER MANUFACTURER SPECIFICATIONS. SEE DETAIL 25/C1-1C/J AND SITE FURNISHING SPECIFICATIONS.

(2) SLAPX-36L, APEX RECEPTACLE, 36-GALLON, SPLIT-STREAM, FSC 100% JATOBÁ HARDWOOD, WITH RAIN COVER, LITTER AND RECYCLING GRAPHICS, SURFACE MOUNT. INCLUDE (1) SUBUT-MDR-MOD, MEDIUM SQUARE BUTTLER, MOUNTED TO SIDE OF RECEPTACLE. INSTALL PER MANUFACTURER SPECIFICATIONS.

(X) SLAPX-136L, APEX RECEPTACLE, 36-GALLON, SINGLE-STREAM, FSC 100% JATOBÁ HARDWOOD, WITH RAIN COVER, LITTER GRAPHICS, SURFACE MOUNT. INSTALL PER MANUFACTURER SPECIFICATIONS.

(X) SLAPX-136L, APEX RECEPTACLE, 36-GALLON, SINGLE-STREAM, FSC 100% JATOBÁ HARDWOOD, WITH RAIN COVER, RECYCLING GRAPHICS, SURFACE MOUNT. INCLUDE (1) SUBUT-MDR-MOD, MEDIUM SQUARE BUTTLER, MOUNTED TO SIDE OF RECEPTACLE. INSTALL PER MANUFACTURER SPECIFICATIONS.

NEW HIGH-SIDE CURB & GUTTER SEE DETAIL 10/C1-1C/H

NEW LOW-SIDE CURB & GUTTER SEE DETAIL 10/C1-1C/H




WISCONSIN ENTERTAINMENT & SPORTS CENTER

1111 N. 4TH STREET  
MILWAUKEE WI

DPD - MINOR MODIFICATION

REVISIONS

NO.	DATE	DESCRIPTION
1	03.17.2016	ISSUED
2	04.04.2016	REVISED
3	05.09.2016	REVISED
4	01.27.2017	REVISED

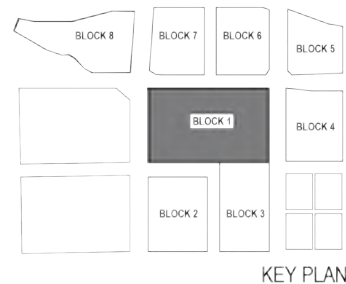

KEY PLAN

PROJECT NUMBER: 15.4017


ISSUE DATE: 01.27.2017

OVERALL SITE PLAN

POPULOUS HNTB eua

SHEET  
A1 - 3



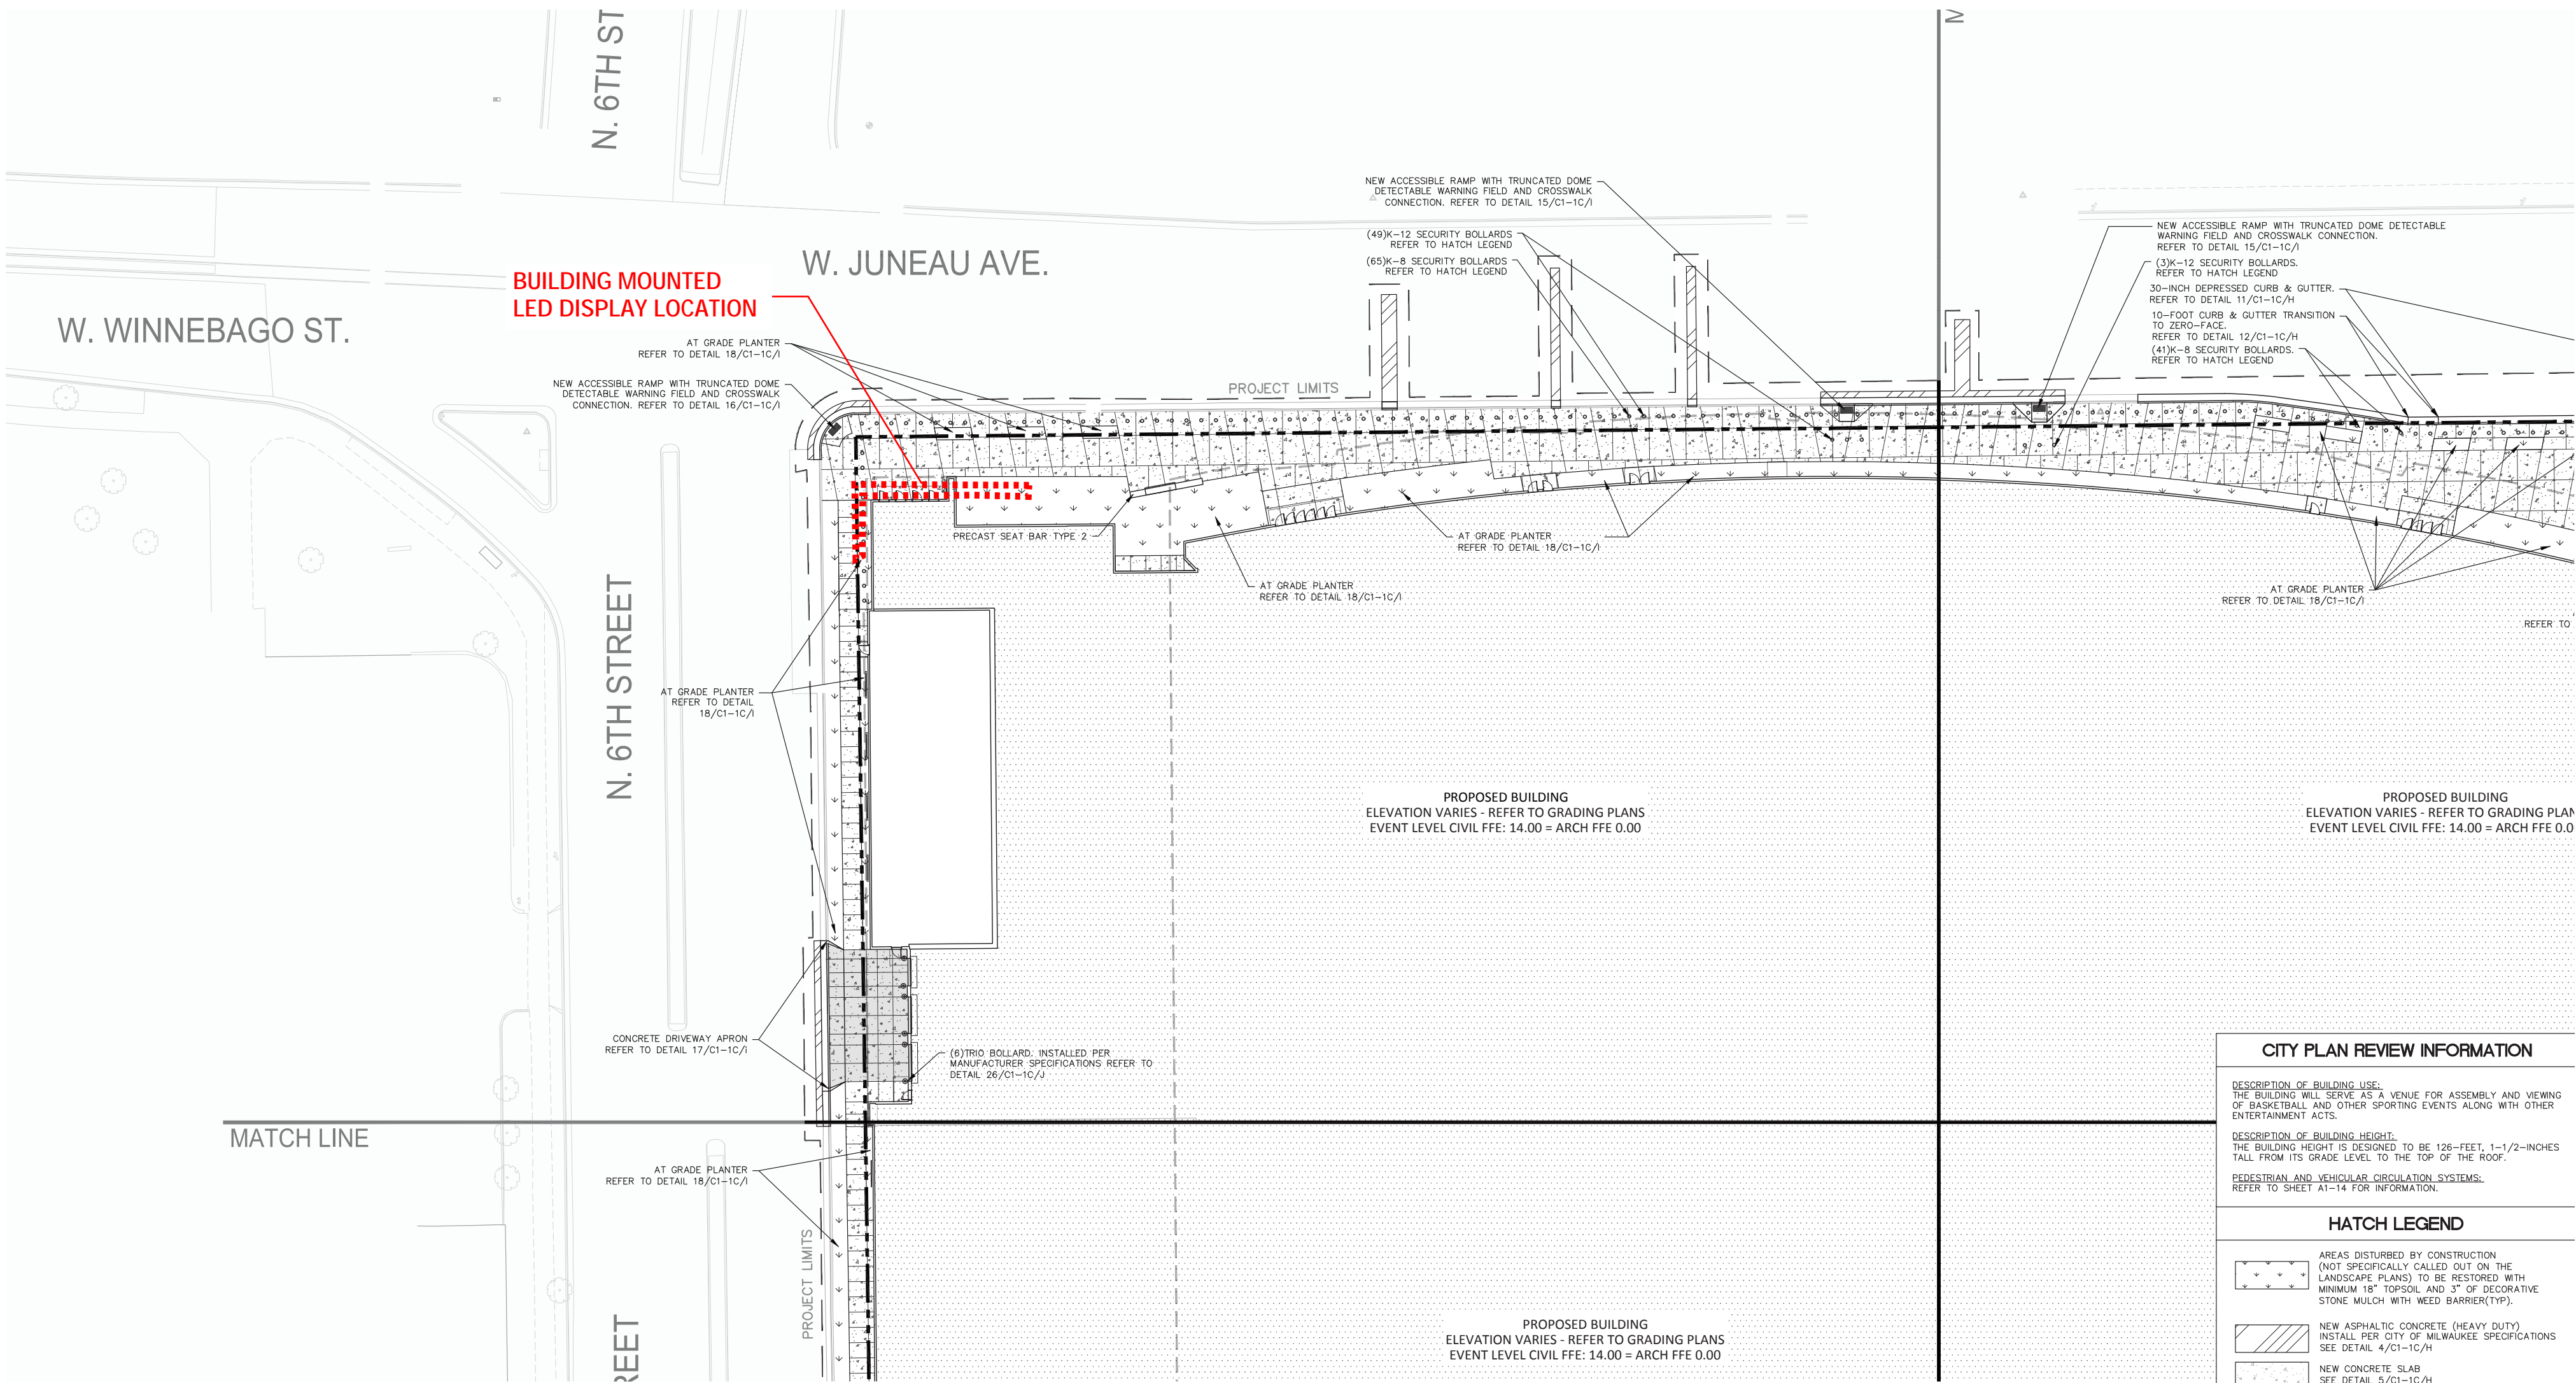


**CITY PLAN REVIEW INFORMATION**

**DESCRIPTION OF BUILDING USE:**  
THE BUILDING WILL SERVE AS A VENUE FOR ASSEMBLY AND VIEWING OF BASKETBALL AND OTHER SPORTING EVENTS ALONG WITH OTHER ENTERTAINMENT ACTS.

**DESCRIPTION OF BUILDING HEIGHT:**  
THE BUILDING HEIGHT IS DESIGNED TO BE 126- FEET, 1-1/2- INCHES TALL FROM ITS GRADE LEVEL TO THE TOP OF THE ROOF.

**PEDESTRIAN AND VEHICULAR CIRCULATION SYSTEMS:**  
REFER TO SHEET A1-14 FOR INFORMATION.

- HATCH LEGEND**
- AREAS DISTURBED BY CONSTRUCTION  
(NOT SPECIFICALLY CALLED OUT ON THE LANDSCAPE PLANS) TO BE RESTORED WITH MINIMUM 18" TOPSOIL AND 3" OF DECORATIVE STONE MULCH WITH WEED BARRIER(TYP).
  - NEW ASPHALTIC CONCRETE (HEAVY DUTY)  
INSTALL PER CITY OF MILWAUKEE SPECIFICATIONS  
SEE DETAIL 4/C1-1C/H
  - NEW CONCRETE SLAB  
SEE DETAIL 5/C1-1C/H
  - NEW CONCRETE UNIT PAVING, TYPE 1  
(VEHICULAR RATED)
  - NEW HEAVY DUTY CONCRETE SLAB  
SEE DETAIL 5/C1-1C/H
  - CLAY BRICK PAVERS, TYPE 1  
(VEHICULAR RATED)  
SEE DETAIL 7/C1-1C/H
  - DECOMPOSED GRANITE PAVING  
SEE DETAIL 8/C1-1C/H
  - PAVEDRAIN  
SEE DETAIL 9/C1-1C/H
  - K-4/K-12 SECURITY BOLLARDS, AS NOTED ON PLAN, BY AMERISTAR SECURITY PRODUCTS FITTED WITH TRO-1 BOLLARD SLEEVE BY FORM-SURFACES. INSTALL PER MANUFACTURER SPECIFICATIONS. SEE DETAIL 25/C1-1C/J AND SITE FURNISHING SPECIFICATIONS.
  - (2) SLAPX-36J, APEX RECEPTACLE, 36-GALLON, SPLIT-STREAM, FSC 100% JATOBIA HARDWOOD, WITH RAIN COVER, LITTER AND RECYCLING GRAPHICS. SURFACE MOUNT. INCLUDE (1) SUBUT-MOR-WOOD, MEDIUM SQUARE BUTTLER, MOUNTED TO SIDE OF RECEPTACLE. INSTALL PER MANUFACTURER SPECIFICATIONS.
  - (X) SLAPX-136J, APEX RECEPTACLE, 36-GALLON, SINGLE-STREAM, FSC 100% JATOBIA HARDWOOD, WITH RAIN COVER, LITTER GRAPHICS, SURFACE MOUNT. INSTALL PER MANUFACTURER SPECIFICATIONS.
  - (X) SLAPX-136J, APEX RECEPTACLE, 36-GALLON, SINGLE-STREAM, FSC 100% JATOBIA HARDWOOD, WITH RAIN COVER, RECYCLING GRAPHICS, SURFACE MOUNT. INCLUDE (1) SUBUT-MOR-WOOD, MEDIUM SQUARE BUTTLER, MOUNTED TO SIDE OF RECEPTACLE. INSTALL PER MANUFACTURER SPECIFICATIONS.
  - NEW HIGH-SIDE CURB & GUTTER  
SEE DETAIL 10/C1-1C/H
  - NEW LOW-SIDE CURB & GUTTER  
SEE DETAIL 10/C1-1C/H

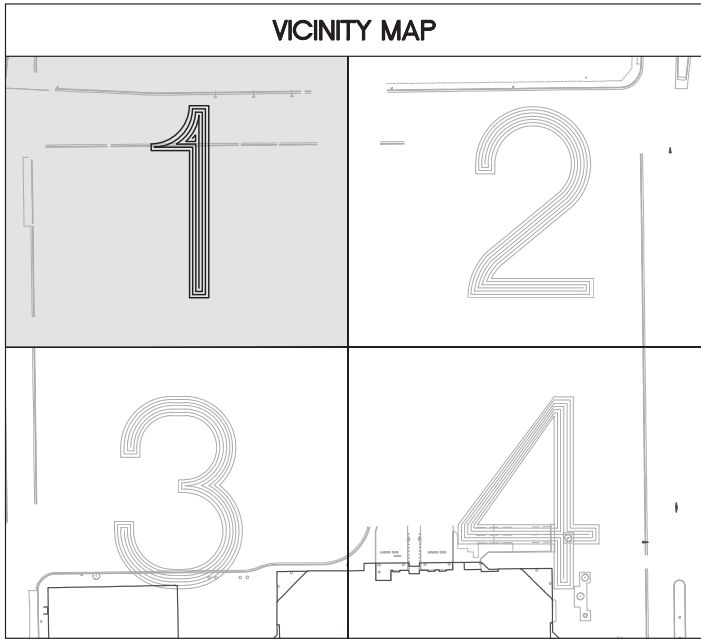

Scale: 1" = 20'

**DIGGERS HOTLINE**

Dial 811 or (800)242-8511

www.DiggersHotline.com




**WISCONSIN ENTERTAINMENT & SPORTS CENTER**

**1111 N. 4TH STREET**

**MILWAUKEE WI**

DPD - MINOR MODIFICATION

REVISIONS		
NO.	DATE	DESCRIPTION
1	03.17.2016	ISSUED
2	04.04.2016	REVISED
3	05.09.2016	REVISED
4	01.27.2017	REVISED

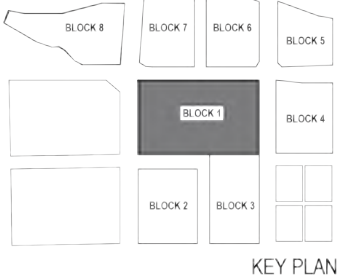

PROJECT NUMBER: 15.4017

ISSUE DATE: 01.27.2017


ENLARGED SITE PLAN -  
6TH & JUNEAU

**POPULOUS** **HNTB** **eua**

**SHEET**

**A1 - 4**



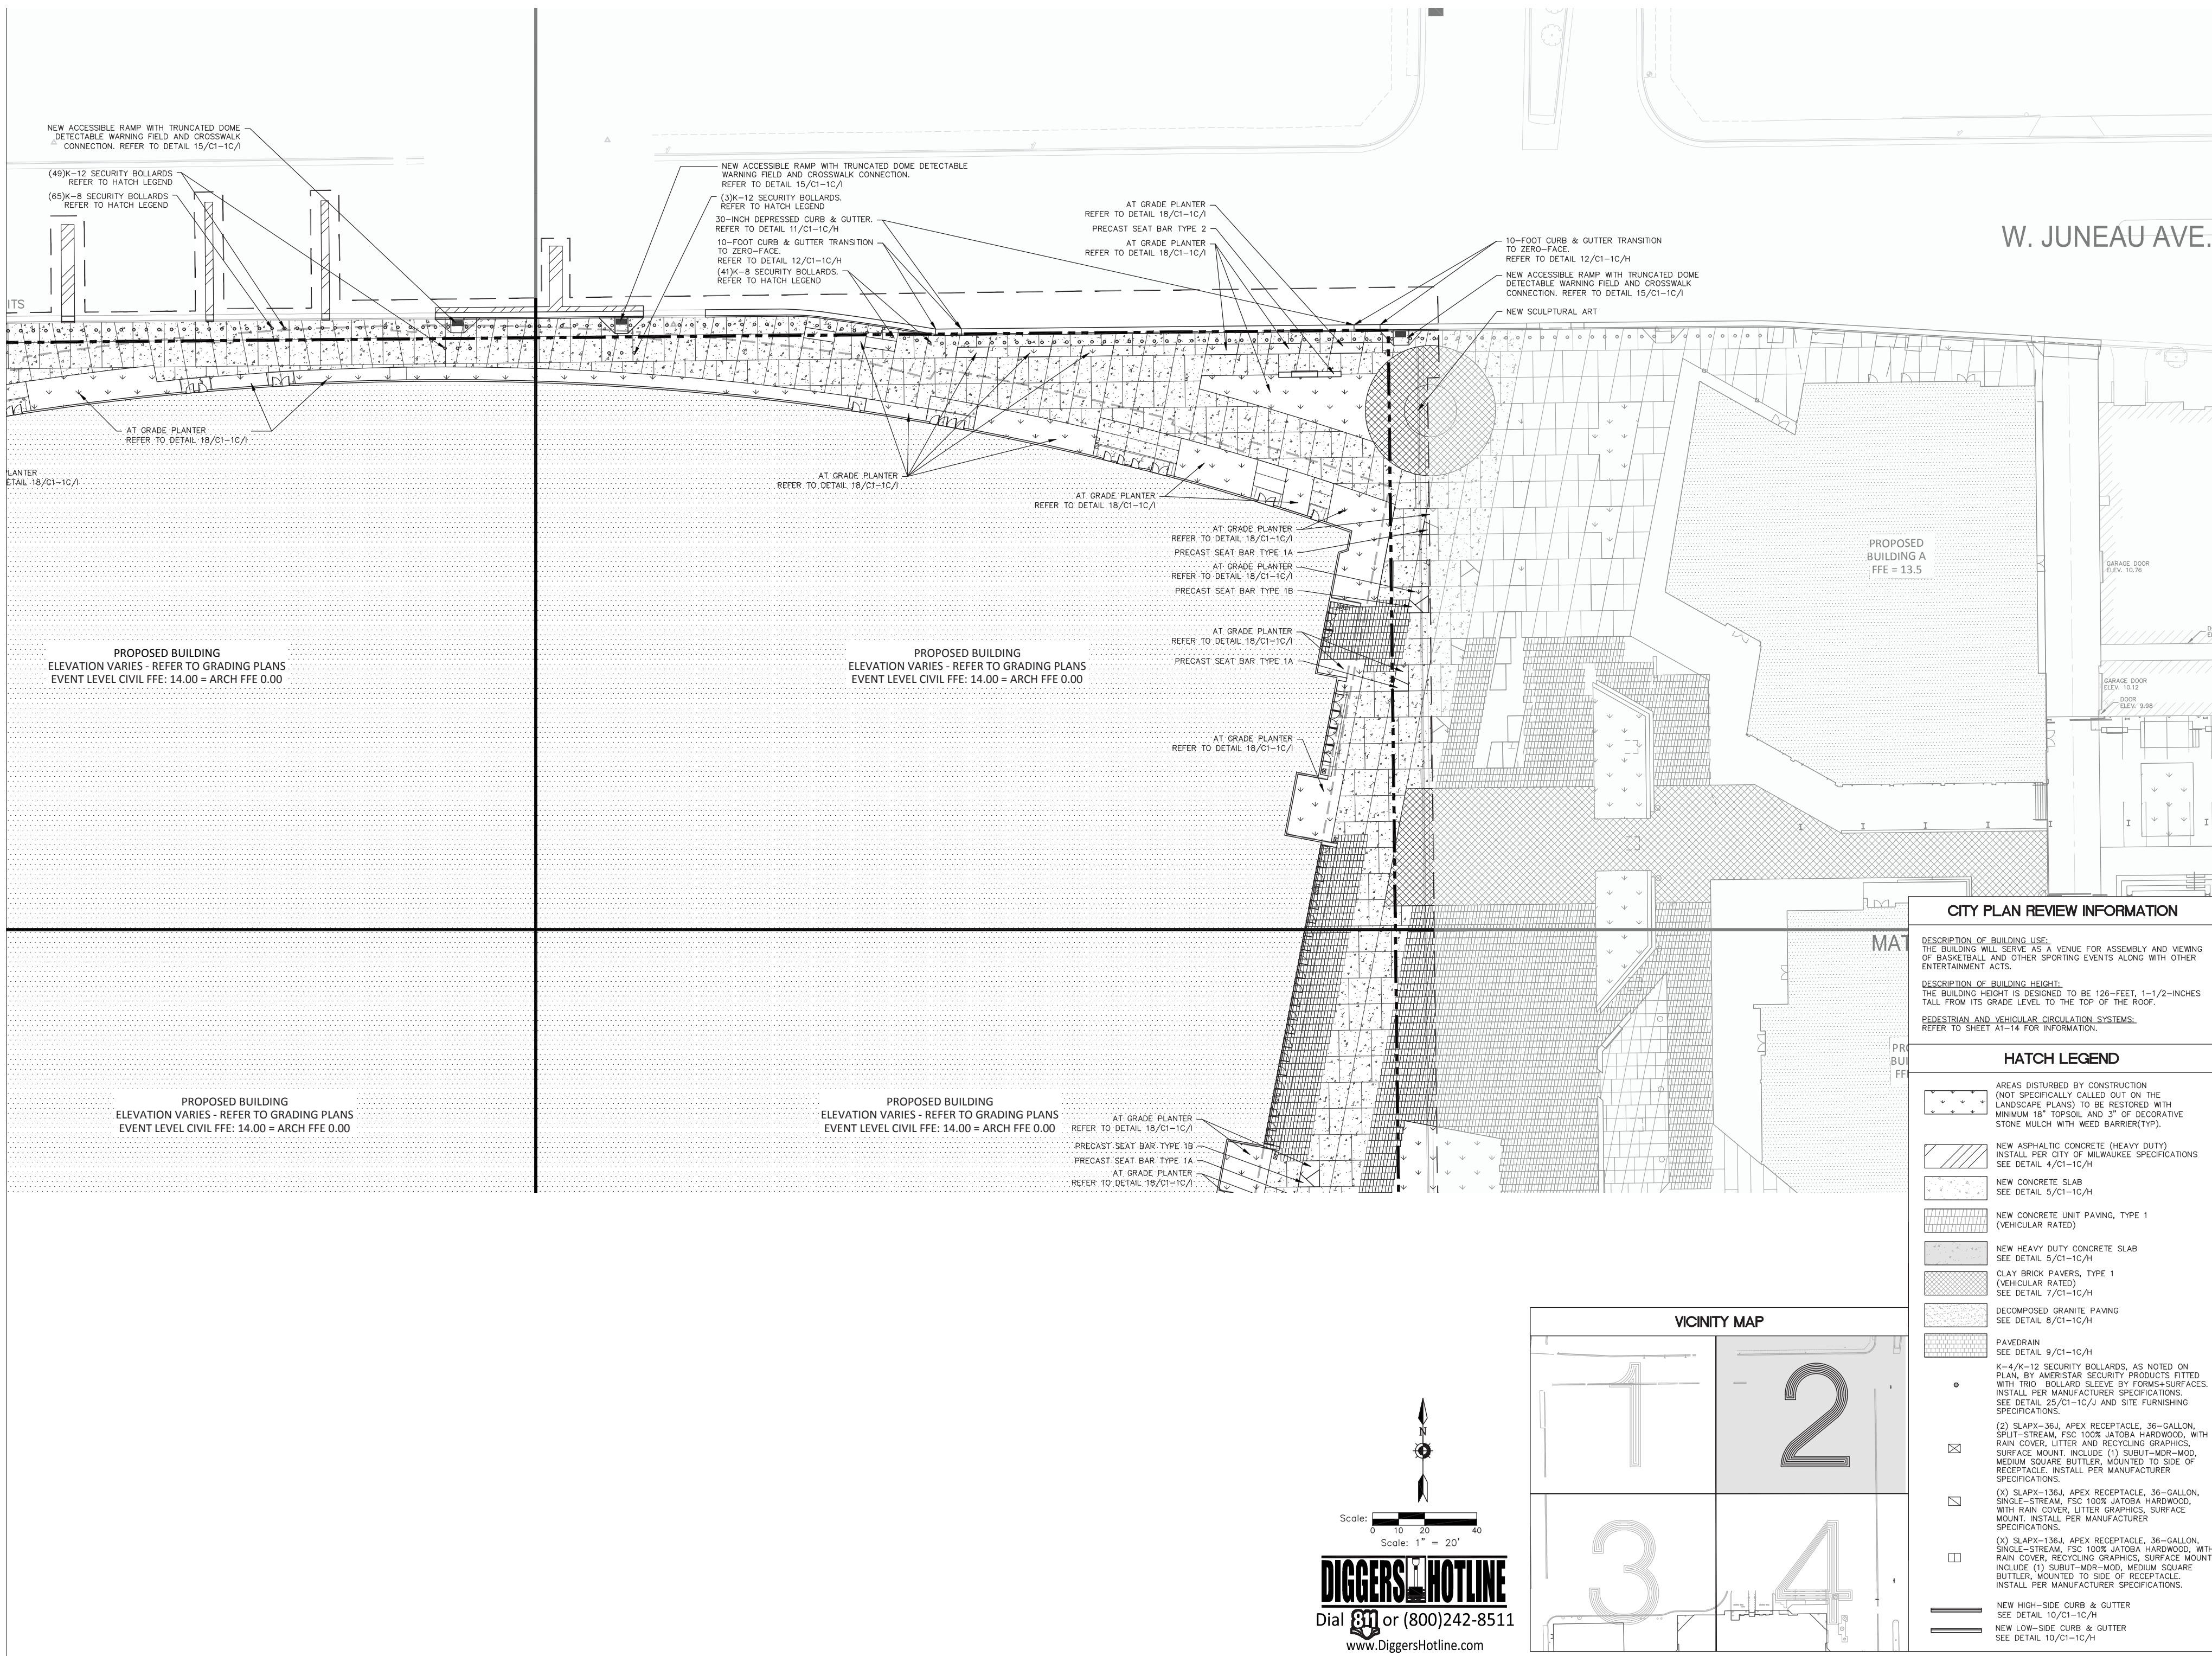

W. JUNEAU AVE.

CITY PLAN REVIEW INFORMATION

DESCRIPTION OF BUILDING USE:  
THE BUILDING WILL SERVE AS A VENUE FOR ASSEMBLY AND VIEWING OF BASKETBALL AND OTHER SPORTING EVENTS ALONG WITH OTHER ENTERTAINMENT ACTS.



DESCRIPTION OF BUILDING HEIGHT:  
THE BUILDING HEIGHT IS DESIGNED TO BE 126-FEET, 1-1/2-INCHES TALL FROM ITS GRADE LEVEL TO THE TOP OF THE ROOF.

PEDESTRIAN AND VEHICULAR CIRCULATION SYSTEMS:  
REFER TO SHEET A1-14 FOR INFORMATION.

HATCH LEGEND

- AREAS DISTURBED BY CONSTRUCTION (NOT SPECIFICALLY CALLED OUT ON THE LANDSCAPE PLANS) TO BE RESTORED WITH MINIMUM 18" TOPSOIL AND 3" OF DECORATIVE STONE MULCH WITH WEED BARRIER(TYP).
- NEW ASPHALTIC CONCRETE (HEAVY DUTY) INSTALL PER CITY OF MILWAUKEE SPECIFICATIONS SEE DETAIL 4/C1-1C/H
- NEW CONCRETE SLAB SEE DETAIL 5/C1-1C/H
- NEW CONCRETE UNIT PAVING, TYPE 1 (VEHICULAR RATED) SEE DETAIL 5/C1-1C/H
- NEW HEAVY DUTY CONCRETE SLAB SEE DETAIL 5/C1-1C/H
- CLAY BRICK PAVERS, TYPE 1 (VEHICULAR RATED) SEE DETAIL 7/C1-1C/H
- DECOMPOSED GRANITE PAVING SEE DETAIL 8/C1-1C/H
- PAVEDRAIN SEE DETAIL 9/C1-1C/H
- K-4/K-12 SECURITY BOLLARDS, AS NOTED ON PLAN, BY AMERISTAR SECURITY PRODUCTS FITTED WITH TRIO BOLLARD SLEEVE BY FORMS+SURFACES. INSTALL PER MANUFACTURER SPECIFICATIONS. SEE DETAIL 25/C1-1C/J AND SITE FURNISHING SPECIFICATIONS.
- (2) SLAPX-36J, APEX RECEPTACLE, 36-GALLON, SPLIT-STREAM, FSC 100% JATOBIA HARDWOOD, WITH RAIN COVER, LITTER AND RECYCLING GRAPHICS, SURFACE MOUNT. INCLUDE (1) SUBUT-MDR-MOD, MEDIUM SQUARE BUTTLER, MOUNTED TO SIDE OF RECEPTACLE. INSTALL PER MANUFACTURER SPECIFICATIONS.
- (4) SLAPX-136J, APEX RECEPTACLE, 36-GALLON, SINGLE-STREAM, FSC 100% JATOBIA HARDWOOD, WITH RAIN COVER, LITTER GRAPHICS, SURFACE MOUNT. INSTALL PER MANUFACTURER SPECIFICATIONS.
- (X) SLAPX-136J, APEX RECEPTACLE, 36-GALLON, SINGLE-STREAM, FSC 100% JATOBIA HARDWOOD, WITH RAIN COVER, RECYCLING GRAPHICS, SURFACE MOUNT. INCLUDE (1) SUBUT-MDR-MOD, MEDIUM SQUARE BUTTLER, MOUNTED TO SIDE OF RECEPTACLE. INSTALL PER MANUFACTURER SPECIFICATIONS.
- NEW HIGH-SIDE CURB & GUTTER SEE DETAIL 10/C1-1C/H
- NEW LOW-SIDE CURB & GUTTER SEE DETAIL 10/C1-1C/H


VICINITY MAP

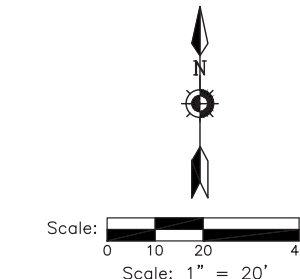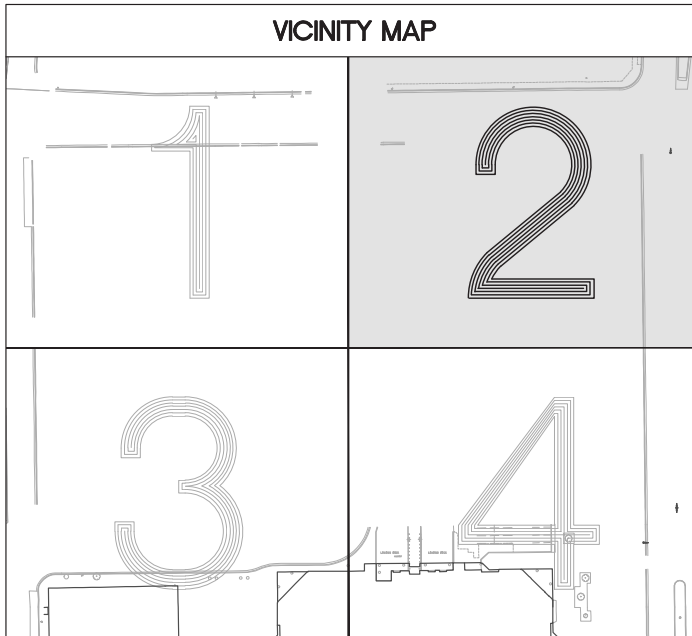

**DIGGERS HOTLINE**  
Dial 811 or (800)242-8511  
www.DiggersHotline.com

REVISIONS

NO.	DATE	DESCRIPTION
1	03.17.2016	ISSUED
2	04.04.2016	REVISED
3	05.09.2016	REVISED
4	01.27.2017	REVISED

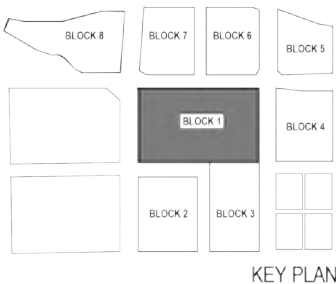

KEY PLAN

PROJECT NUMBER: 15.4017  
ISSUE DATE: 01.27.2017

ENLARGED SITE PLAN -  
4TH & JUNEAU

POPULOUS HNTB eua




**WISCONSIN ENTERTAINMENT & SPORTS CENTER**  
**1111 N. 4TH STREET**  
**MILWAUKEE WI**

DPD - MINOR MODIFICATION

**SHEET**  
**A1 - 5**



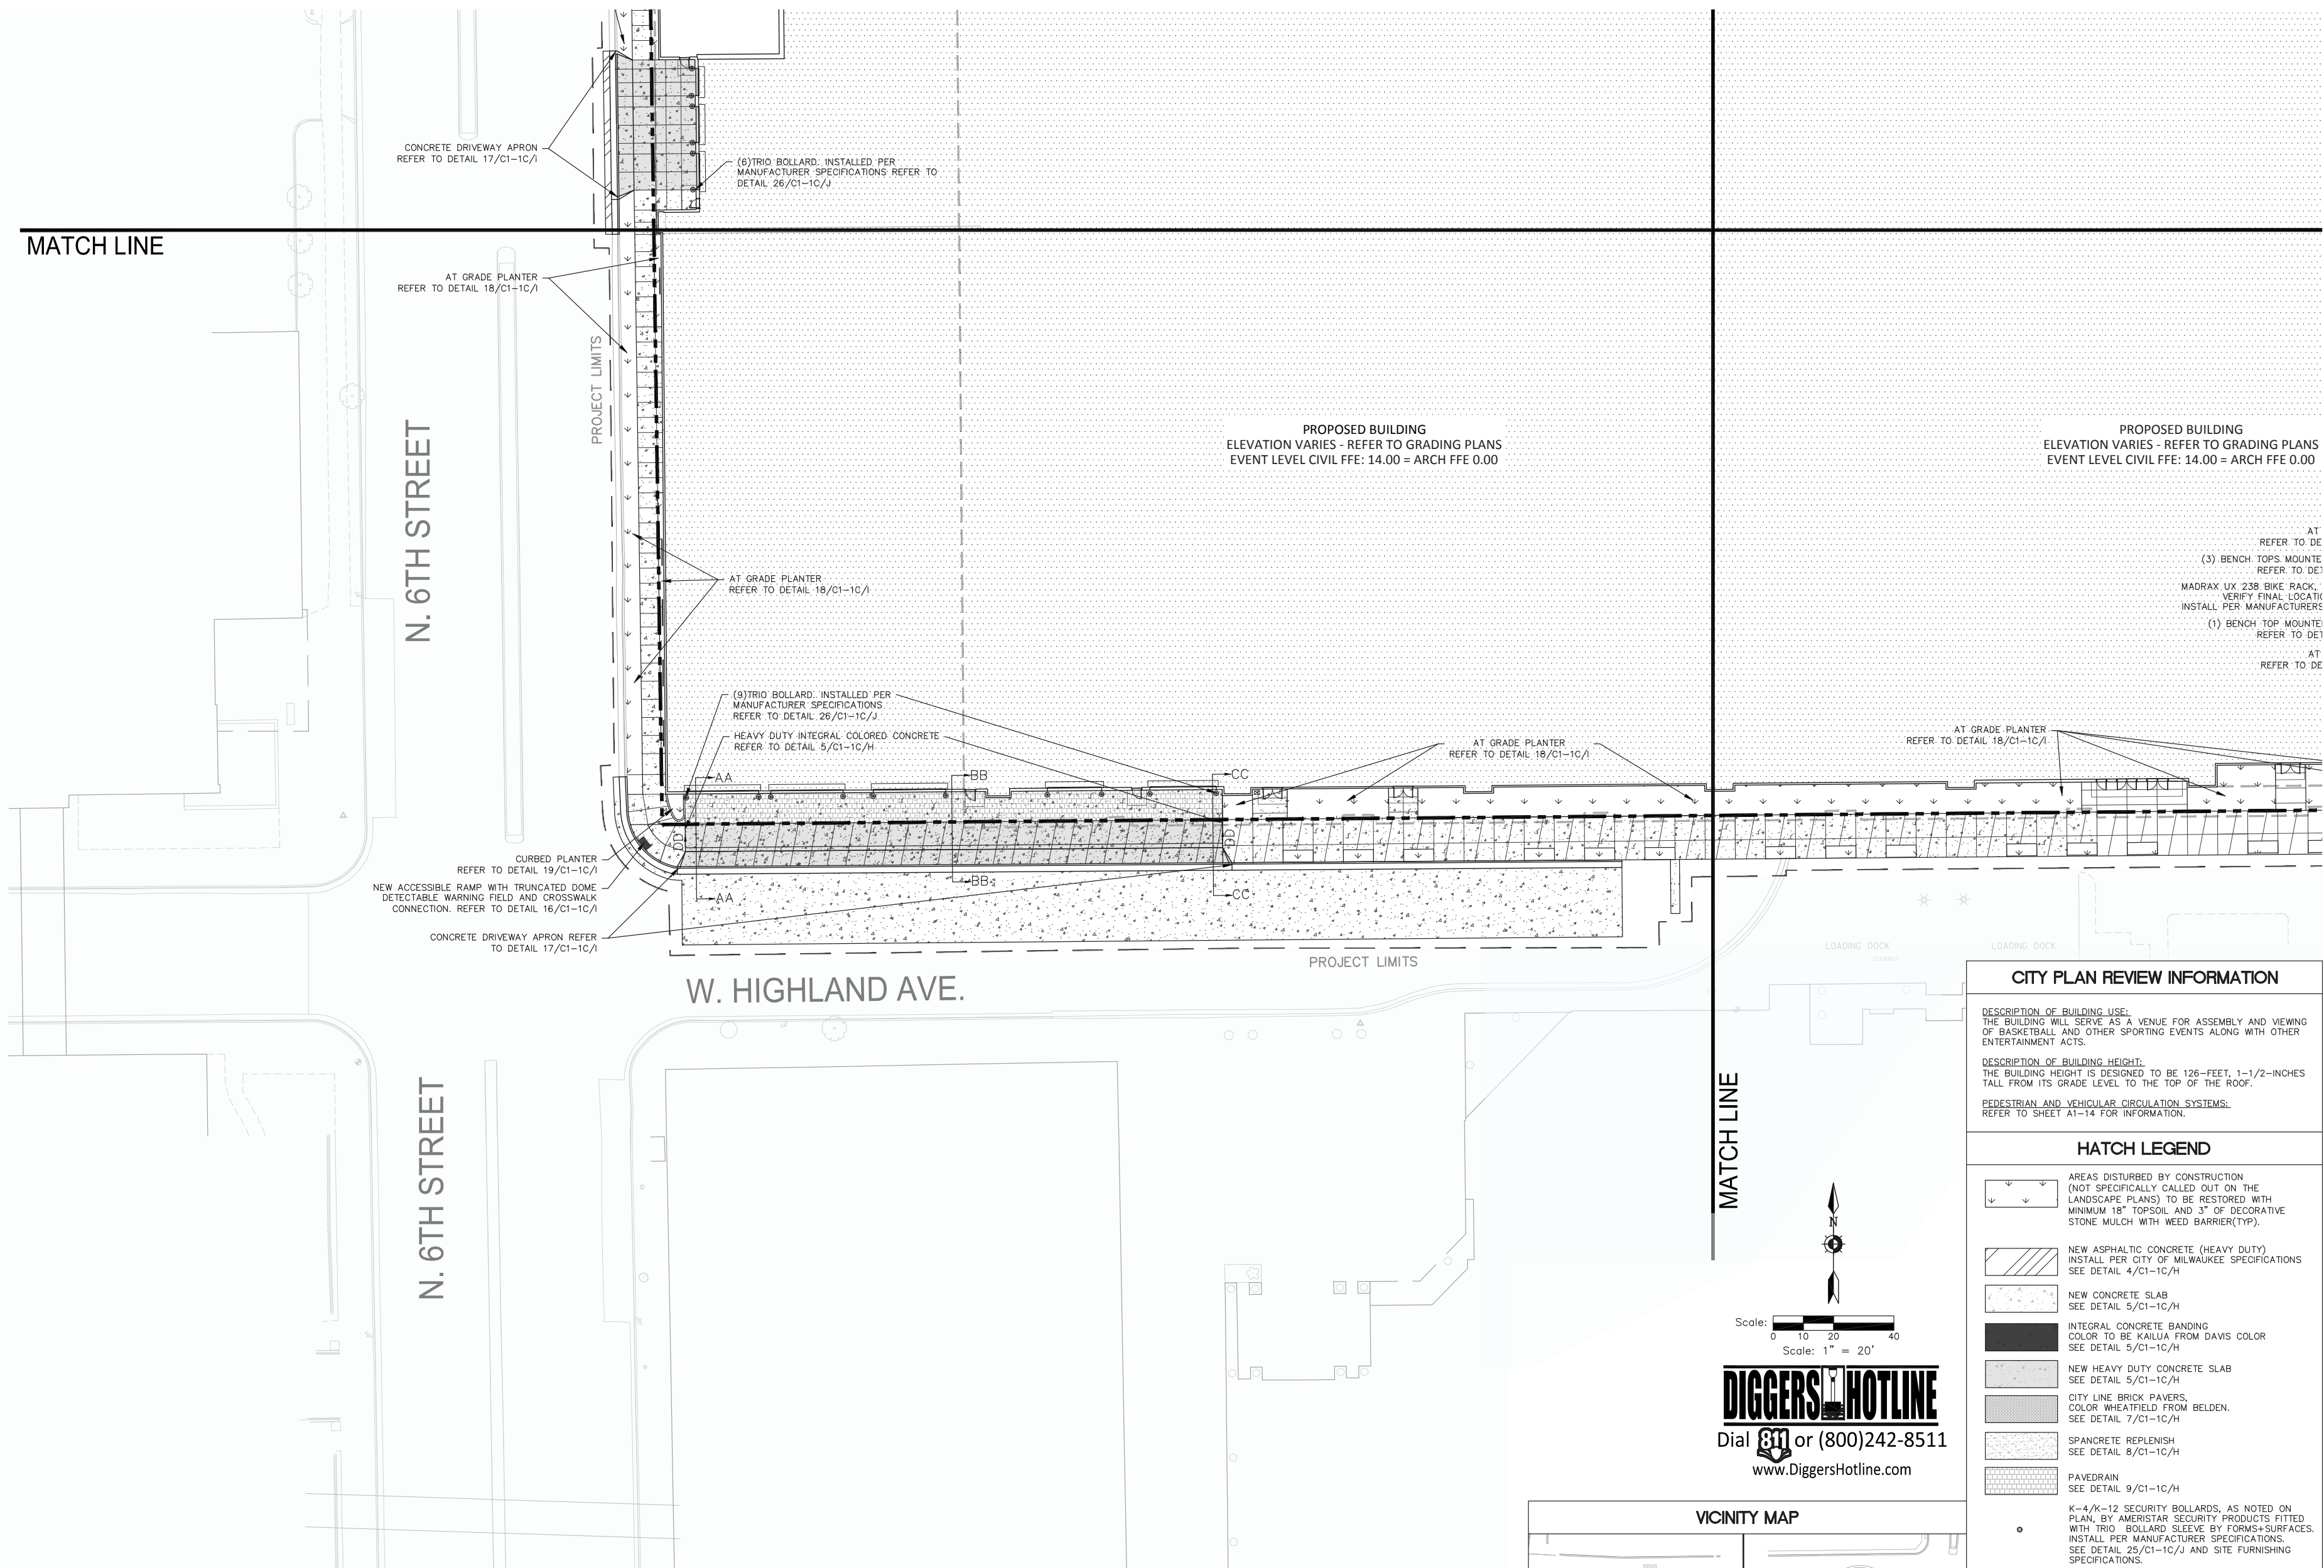

**CITY PLAN REVIEW INFORMATION**

**DESCRIPTION OF BUILDING USE:**  
THE BUILDING WILL SERVE AS A VENUE FOR ASSEMBLY AND VIEWING OF BASKETBALL AND OTHER SPORTING EVENTS ALONG WITH OTHER ENTERTAINMENT ACTS.

**DESCRIPTION OF BUILDING HEIGHT:**  
THE BUILDING HEIGHT IS DESIGNED TO BE 126- FEET, 1-1/2- INCHES TALL FROM ITS GRADE LEVEL TO THE TOP OF THE ROOF.

**PEDESTRIAN AND VEHICULAR CIRCULATION SYSTEMS:**  
REFER TO SHEET A1-14 FOR INFORMATION.

**HATCH LEGEND**

AREAS DISTURBED BY CONSTRUCTION (NOT SPECIFICALLY CALLED OUT ON THE LANDSCAPE PLANS) TO BE RESTORED WITH MINIMUM 18" TOPSOIL AND 3" OF DECORATIVE STONE MULCH WITH WEED BARRIER(TYP).

NEW ASPHALTIC CONCRETE (HEAVY DUTY) INSTALL PER CITY OF MILWAUKEE SPECIFICATIONS SEE DETAIL 4/C1-1C/H

NEW CONCRETE SLAB SEE DETAIL 5/C1-1C/H

INTEGRAL CONCRETE BANDING COLOR TO BE KAULIA FROM DAVIS COLOR SEE DETAIL 5/C1-1C/H

NEW HEAVY DUTY CONCRETE SLAB SEE DETAIL 5/C1-1C/H

CITY LINE BRICK PAVERS, COLOR WHEATFIELD FROM BELDEN. SEE DETAIL 7/C1-1C/H

SPANDREL REPLENISH SEE DETAIL 8/C1-1C/H

PAVEDRAIN SEE DETAIL 9/C1-1C/H

K-4/K-12 SECURITY BOLLARDS, AS NOTED ON PLAN, BY AMERISTAR SECURITY PRODUCTS FITTED WITH TRIO BOLLARD SLEEVE BY FORMS+SURFACES. INSTALL PER MANUFACTURER SPECIFICATIONS. SEE DETAIL 25/C1-1C/J AND SITE FURNISHING SPECIFICATIONS.

TREE GRATE SEE DETAIL 27 & 28/C1-1C/J

WISCONSIN DOLOMITIC LIMESTONE BUFF/GRAY IN COLOR. INSTALL PRIOR TO POURING CONCRETE SEE DETAIL 22 & 23/C1-1C/J



(2) SLAPX-36J, APEX RECEPTACLE, 36-GALLON, SPLIT-STREAM, FSC 100% JATOPA HARDWOOD, WITH RAIN COVER, LITTER AND RECYCLING GRAPHICS, SURFACE MOUNT. INCLUDE (1) SUBUT-MDR-MOD, MEDIUM SQUARE BUTTLER, MOUNTED TO SIDE OF RECEPTACLE. INSTALL PER MANUFACTURER SPECIFICATIONS.

(X) SLAPX-136J, APEX RECEPTACLE, 36-GALLON, SINGLE-STREAM, FSC 100% JATOPA HARDWOOD, WITH RAIN COVER, LITTER GRAPHICS, SURFACE MOUNT. INSTALL PER MANUFACTURER SPECIFICATIONS.

(X) SLAPX-136J, APEX RECEPTACLE, 36-GALLON, SINGLE-STREAM, FSC 100% JATOPA HARDWOOD, WITH RAIN COVER, RECYCLING GRAPHICS, SURFACE MOUNT. INCLUDE (1) SUBUT-MDR-MOD, MEDIUM SQUARE BUTTLER, MOUNTED TO SIDE OF RECEPTACLE. INSTALL PER MANUFACTURER SPECIFICATIONS.

NEW HIGH-SIDE CURB & GUTTER SEE DETAIL 10/C1-1C/H

NEW LOW-SIDE CURB & GUTTER SEE DETAIL 10/C1-1C/H

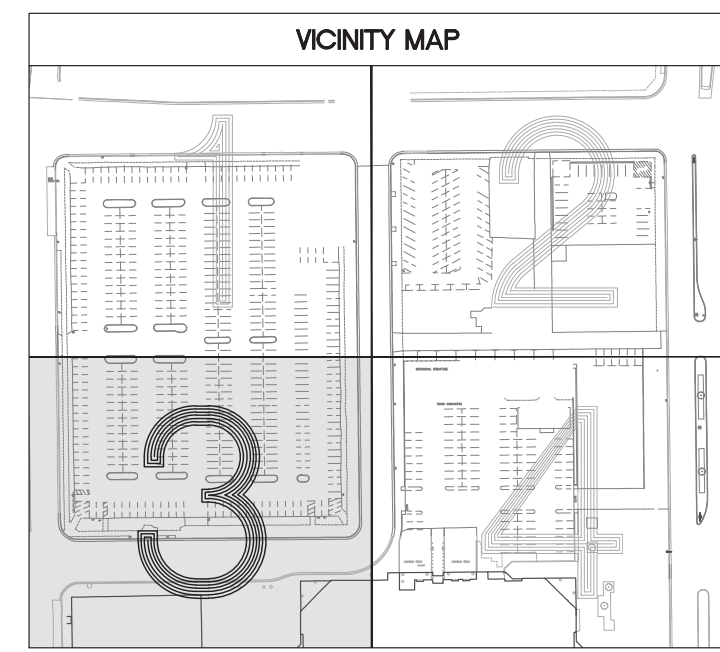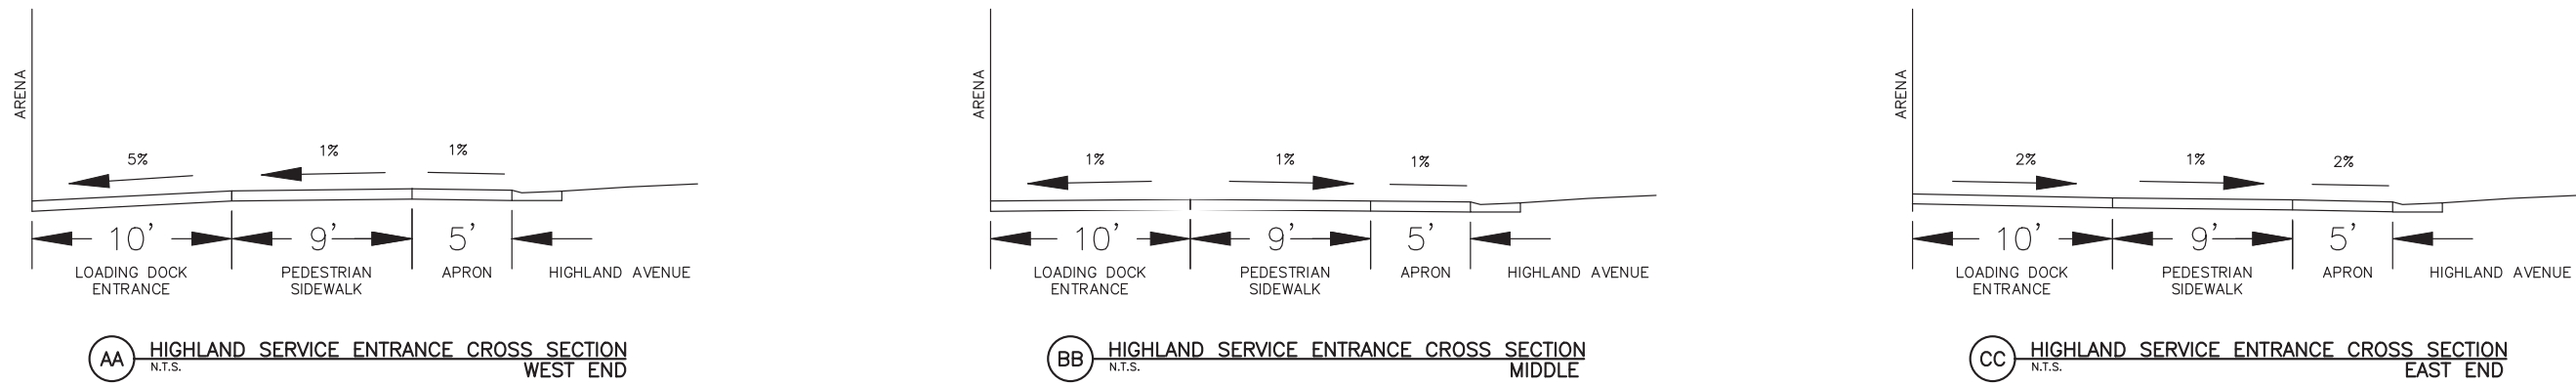


**WISCONSIN ENTERTAINMENT & SPORTS CENTER**  
**1111 N. 4TH STREET**  
**MILWAUKEE WI**

DPD - MINOR MODIFICATION

REVISIONS

NO.	DATE	DESCRIPTION
1	03.17.2016	ISSUED
2	04.04.2016	REVISED
3	05.09.2016	REVISED
4	01.27.2017	REVISED

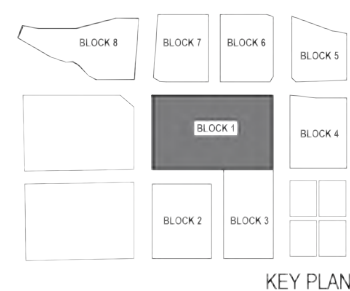


PROJECT NUMBER: 15.4017  
ISSUE DATE: 01.27.2017

ENLARGED SITE PLAN -  
6TH & HIGHLAND

POPULOUS HNTB eua

SHEET  
A1 - 6



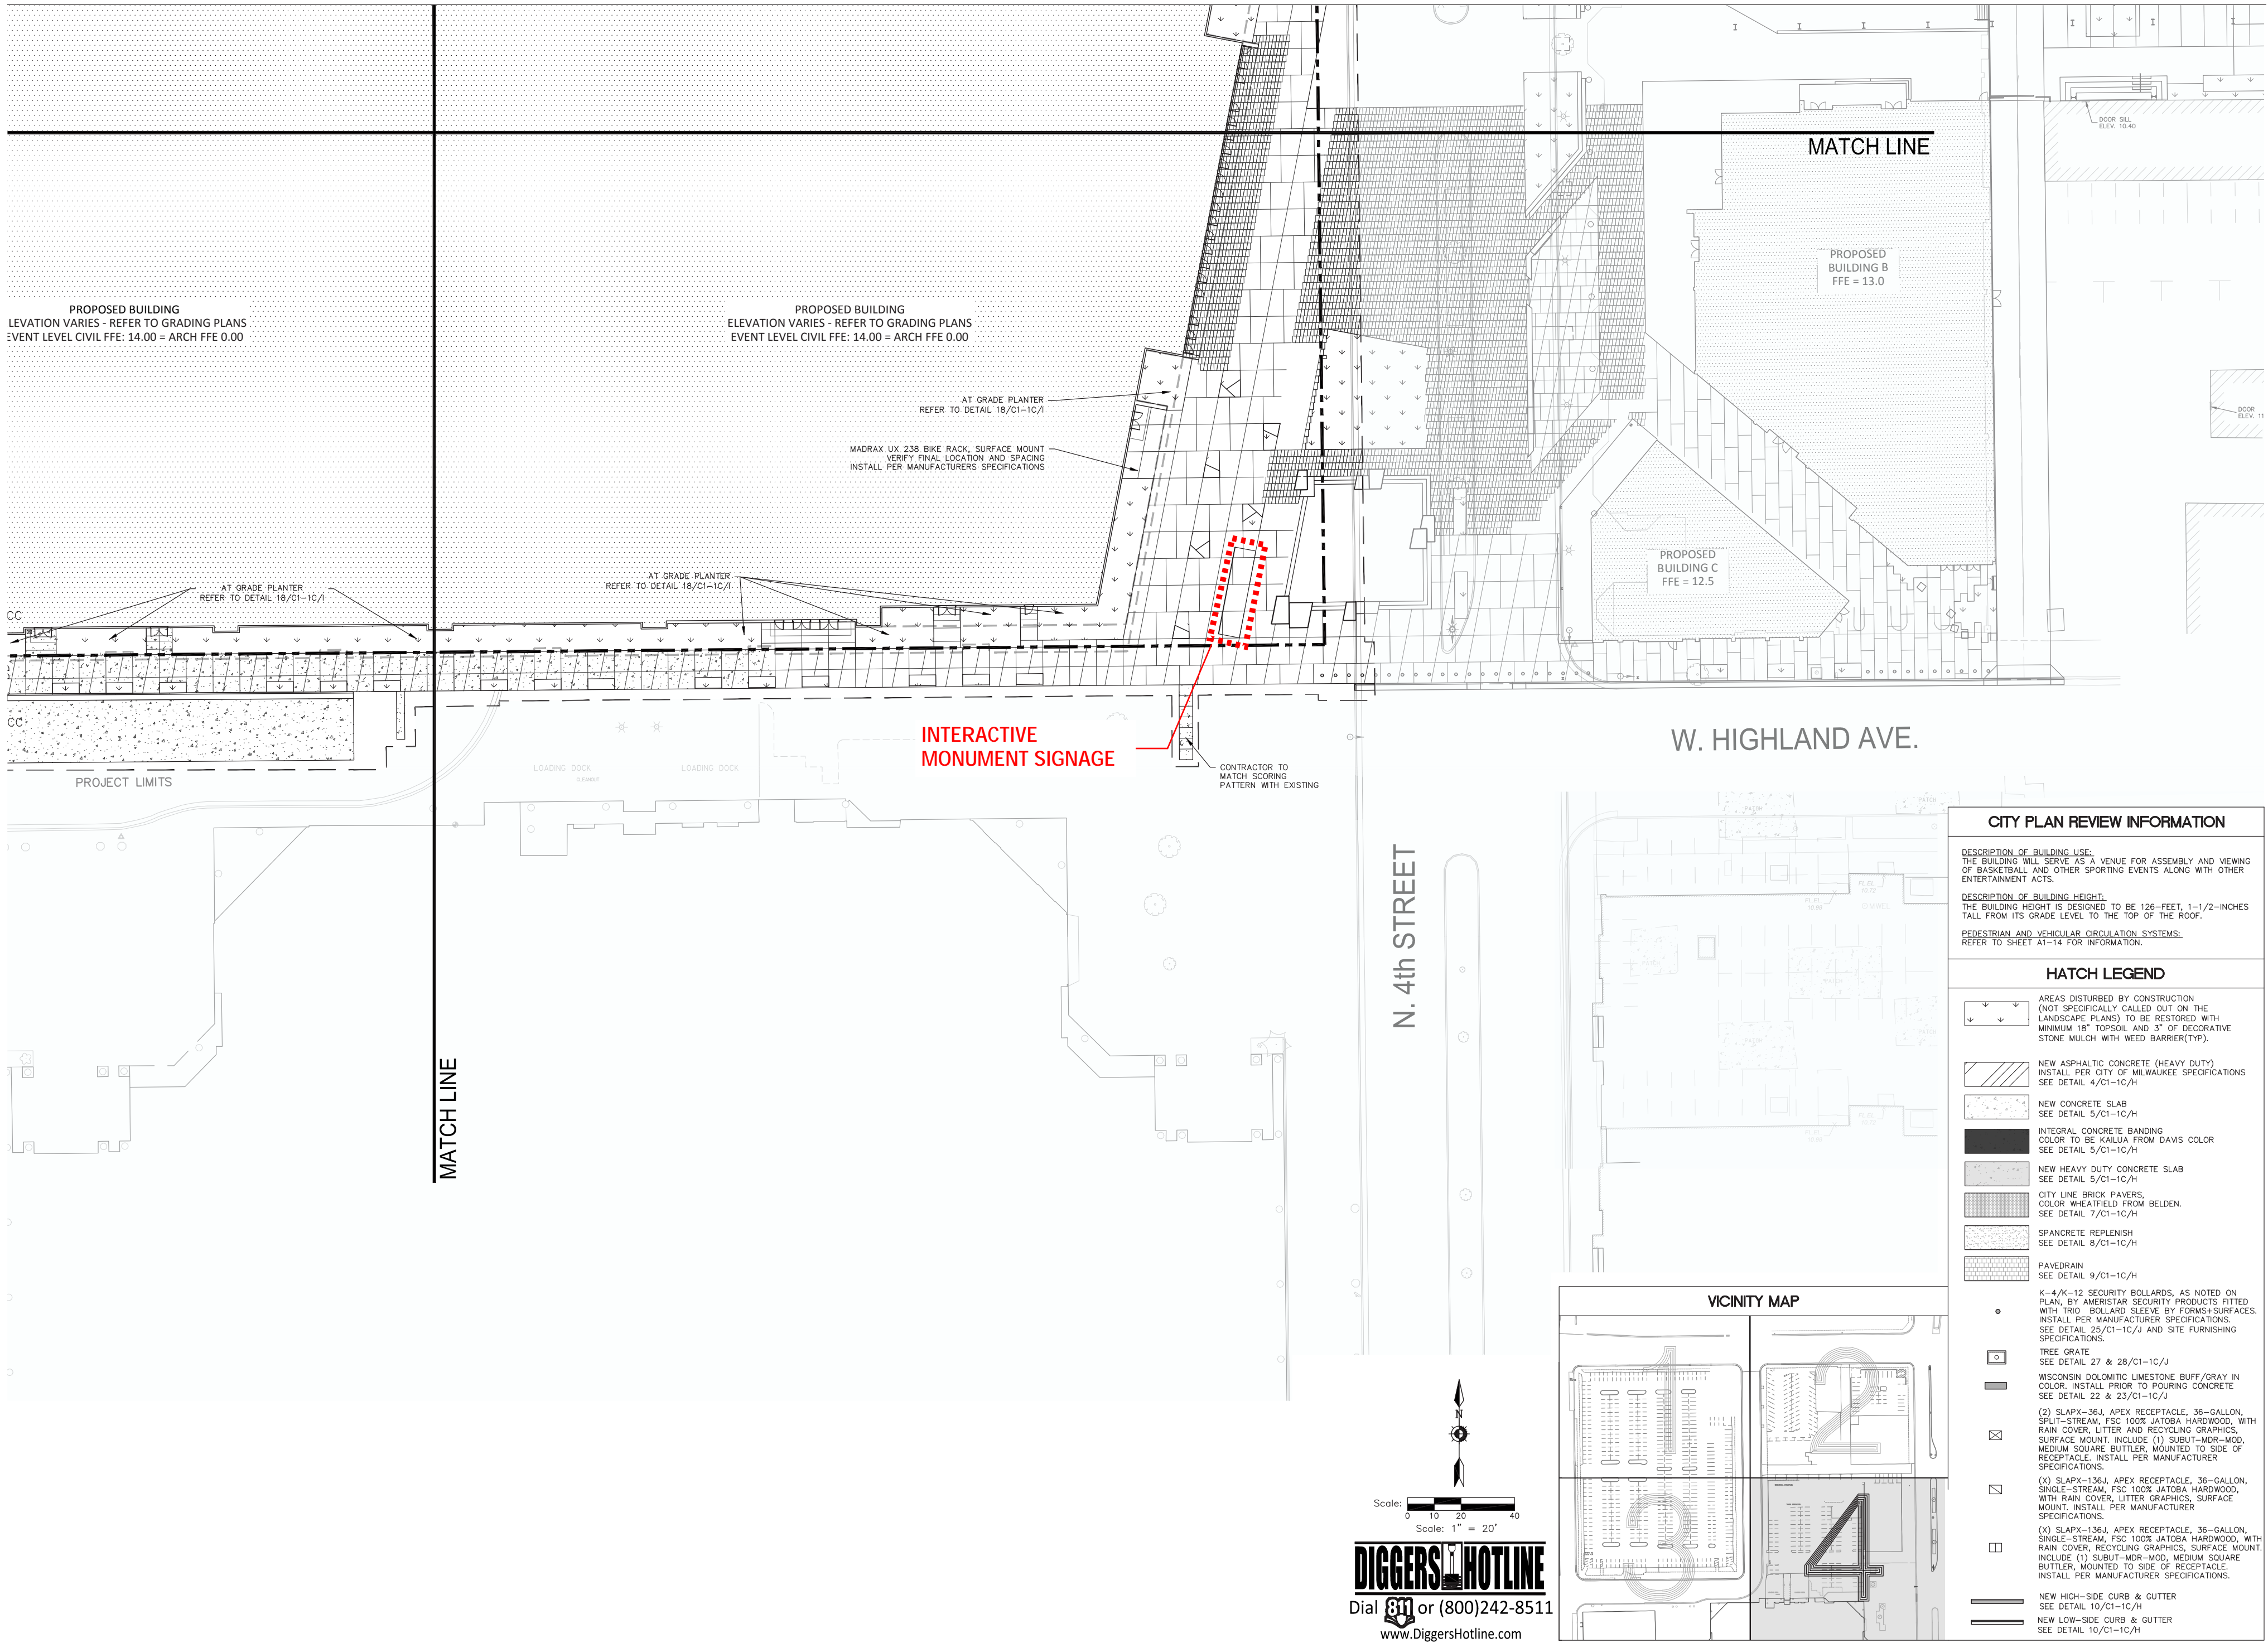

**CITY PLAN REVIEW INFORMATION**

**DESCRIPTION OF BUILDING USE:**  
THE BUILDING WILL SERVE AS A VENUE FOR ASSEMBLY AND VIEWING OF BASKETBALL AND OTHER SPORTING EVENTS ALONG WITH OTHER ENTERTAINMENT ACTS.

**DESCRIPTION OF BUILDING HEIGHT:**  
THE BUILDING HEIGHT IS DESIGNED TO BE 126-FEET, 1-1/2-INCHES TALL FROM ITS GRADE LEVEL TO THE TOP OF THE ROOF.

**PEDESTRIAN AND VEHICULAR CIRCULATION SYSTEMS:**  
REFER TO SHEET A1-14 FOR INFORMATION.

**HATCH LEGEND**

AREAS DISTURBED BY CONSTRUCTION  
(NOT SPECIFICALLY CALLED OUT ON THE LANDSCAPE PLANS) TO BE RESTORED WITH MINIMUM 18" TOPSOIL AND 3" OF DECORATIVE STONE MULCH WITH WEED BARRIER(TYP).

NEW ASPHALTIC CONCRETE (HEAVY DUTY)  
INSTALL PER CITY OF MILWAUKEE SPECIFICATIONS  
SEE DETAIL 4/C1-1C/H

NEW CONCRETE SLAB  
SEE DETAIL 5/C1-1C/H

INTEGRAL CONCRETE BANDING  
COLOR TO BE KAILUA FROM DAVIS COLOR  
SEE DETAIL 5/C1-1C/H

NEW HEAVY DUTY CONCRETE SLAB  
SEE DETAIL 5/C1-1C/H

CITY LINE BRICK PAVERS  
COLOR WHEATFIELD FROM BELDEN.  
SEE DETAIL 7/C1-1C/H

SPANCRETE REPLENISH  
SEE DETAIL 8/C1-1C/H

PAVEDRAIN  
SEE DETAIL 9/C1-1C/H

K-4/K-12 SECURITY BOLLARDS, AS NOTED ON PLAN, BY AMERISTAR SECURITY PRODUCTS FITTED WITH TRIO BOLLARD SLEEVE BY FORMS+SURFACES. INSTALL PER MANUFACTURER SPECIFICATIONS. SEE DETAIL 25/C1-1C/J AND SITE FURNISHING SPECIFICATIONS.

TREE GRATE  
SEE DETAIL 27 & 28/C1-1C/J

WISCONSIN DOLOMITIC LIMESTONE BUFF/GRAY IN COLOR. INSTALL PRIOR TO POURING CONCRETE  
SEE DETAIL 22 & 23/C1-1C/J


(2) SLAPX-36J, APEX RECEPTACLE, 36-GALLON, SPLIT-STREAM, FSC 100% JATOBÁ HARDWOOD, WITH RAIN COVER, LITTER AND RECYCLING GRAPHICS. SURFACE MOUNT. INCLUDE (1) SUBUT-MDR-MOD, MEDIUM SQUARE BUTTLER, MOUNTED TO SIDE OF RECEPTACLE. INSTALL PER MANUFACTURER SPECIFICATIONS.

(X) SLAPX-136J, APEX RECEPTACLE, 36-GALLON, SINGLE-STREAM, FSC 100% JATOBÁ HARDWOOD, WITH RAIN COVER, LITTER GRAPHICS, SURFACE MOUNT. INSTALL PER MANUFACTURER SPECIFICATIONS.

(X) SLAPX-136J, APEX RECEPTACLE, 36-GALLON, SINGLE-STREAM, FSC 100% JATOBÁ HARDWOOD, WITH RAIN COVER, RECYCLING GRAPHICS, SURFACE MOUNT. INCLUDE (1) SUBUT-MDR-MOD, MEDIUM SQUARE BUTTLER, MOUNTED TO SIDE OF RECEPTACLE. INSTALL PER MANUFACTURER SPECIFICATIONS.

NEW HIGH-SIDE CURB & GUTTER  
SEE DETAIL 10/C1-1C/H

NEW LOW-SIDE CURB & GUTTER  
SEE DETAIL 10/C1-1C/H

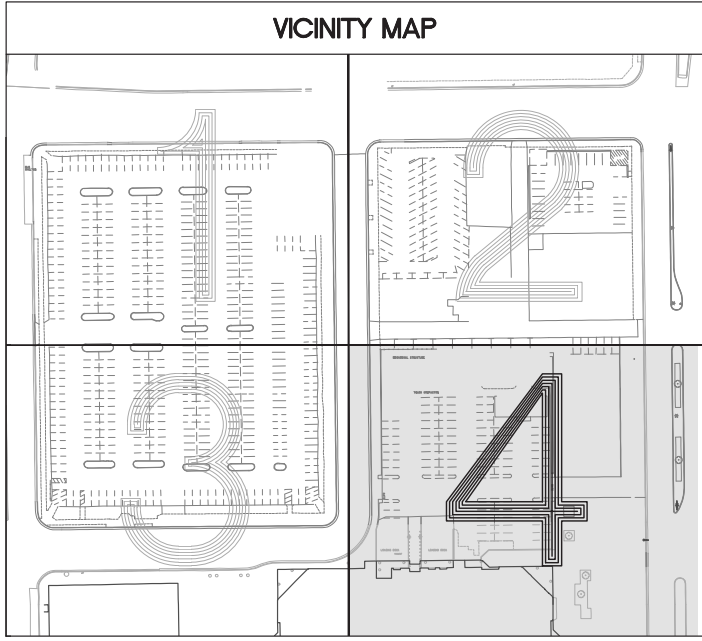


Scale: 1" = 20'

**DIGGERS HOTLINE**  
Dial 311 or (800)242-8511  
www.DiggersHotline.com

REVISIONS

NO.	DATE	DESCRIPTION
1	03.17.2016	ISSUED
2	04.04.2016	REVISED
3	05.09.2016	REVISED
4	01.27.2017	REVISED

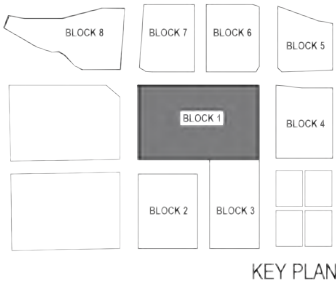

PROJECT NUMBER: 15.4017  
ISSUE DATE: 01.27.2017

ENLARGED SITE PLAN -  
4TH & HIGHLAND

POPULOUS HNTB eua



**WISCONSIN ENTERTAINMENT & SPORTS CENTER**  
**1111 N. 4TH STREET**  
**MILWAUKEE WI**  
DPD - MINOR MODIFICATION

**SHEET**  
**A1 - 7**